


22'-8"

53'-0"

15'-0"

15'-4"

SCALE: 3/32" = 1'-0"

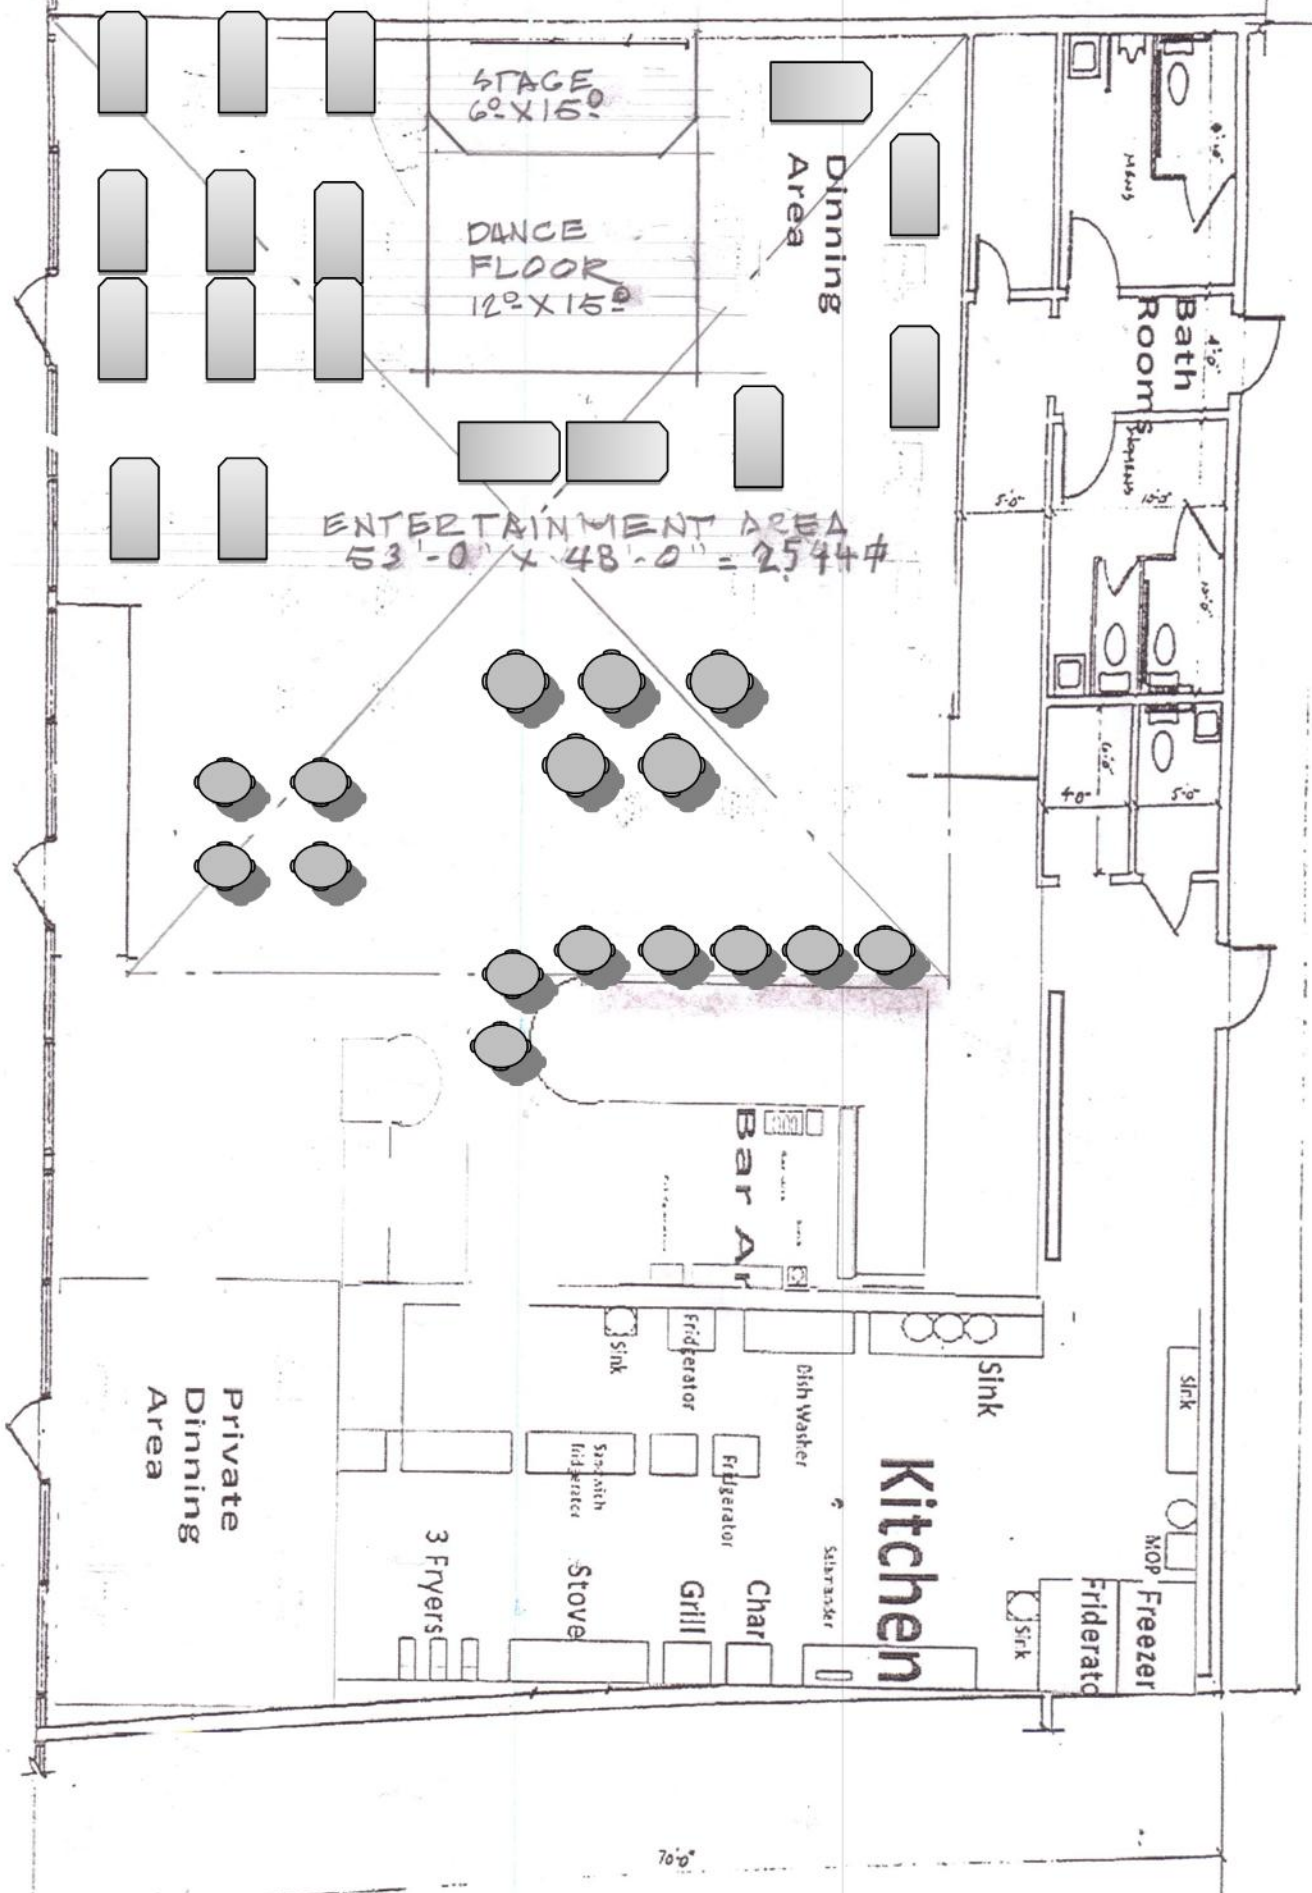

ENTERTAINMENT AREA
53'-0" X 48'-0" = 2544#

Dining Area

DANCE FLOOR
12' X 15'

STAGE
60' X 15'

Bath Room

BAR

Kitchen

Private Dining Area

Sink

MOP Freezer

Fridgerator

Sink

Dish Washer

Fridgerator

Fridgerator

Sink

SINK/STOVE

Char

Grill

Stove

Sandwich
Fridgerator

3 Fryers

AS BUILT FLOOR PLAN
1/8/10

70'-0"